


OPTION A

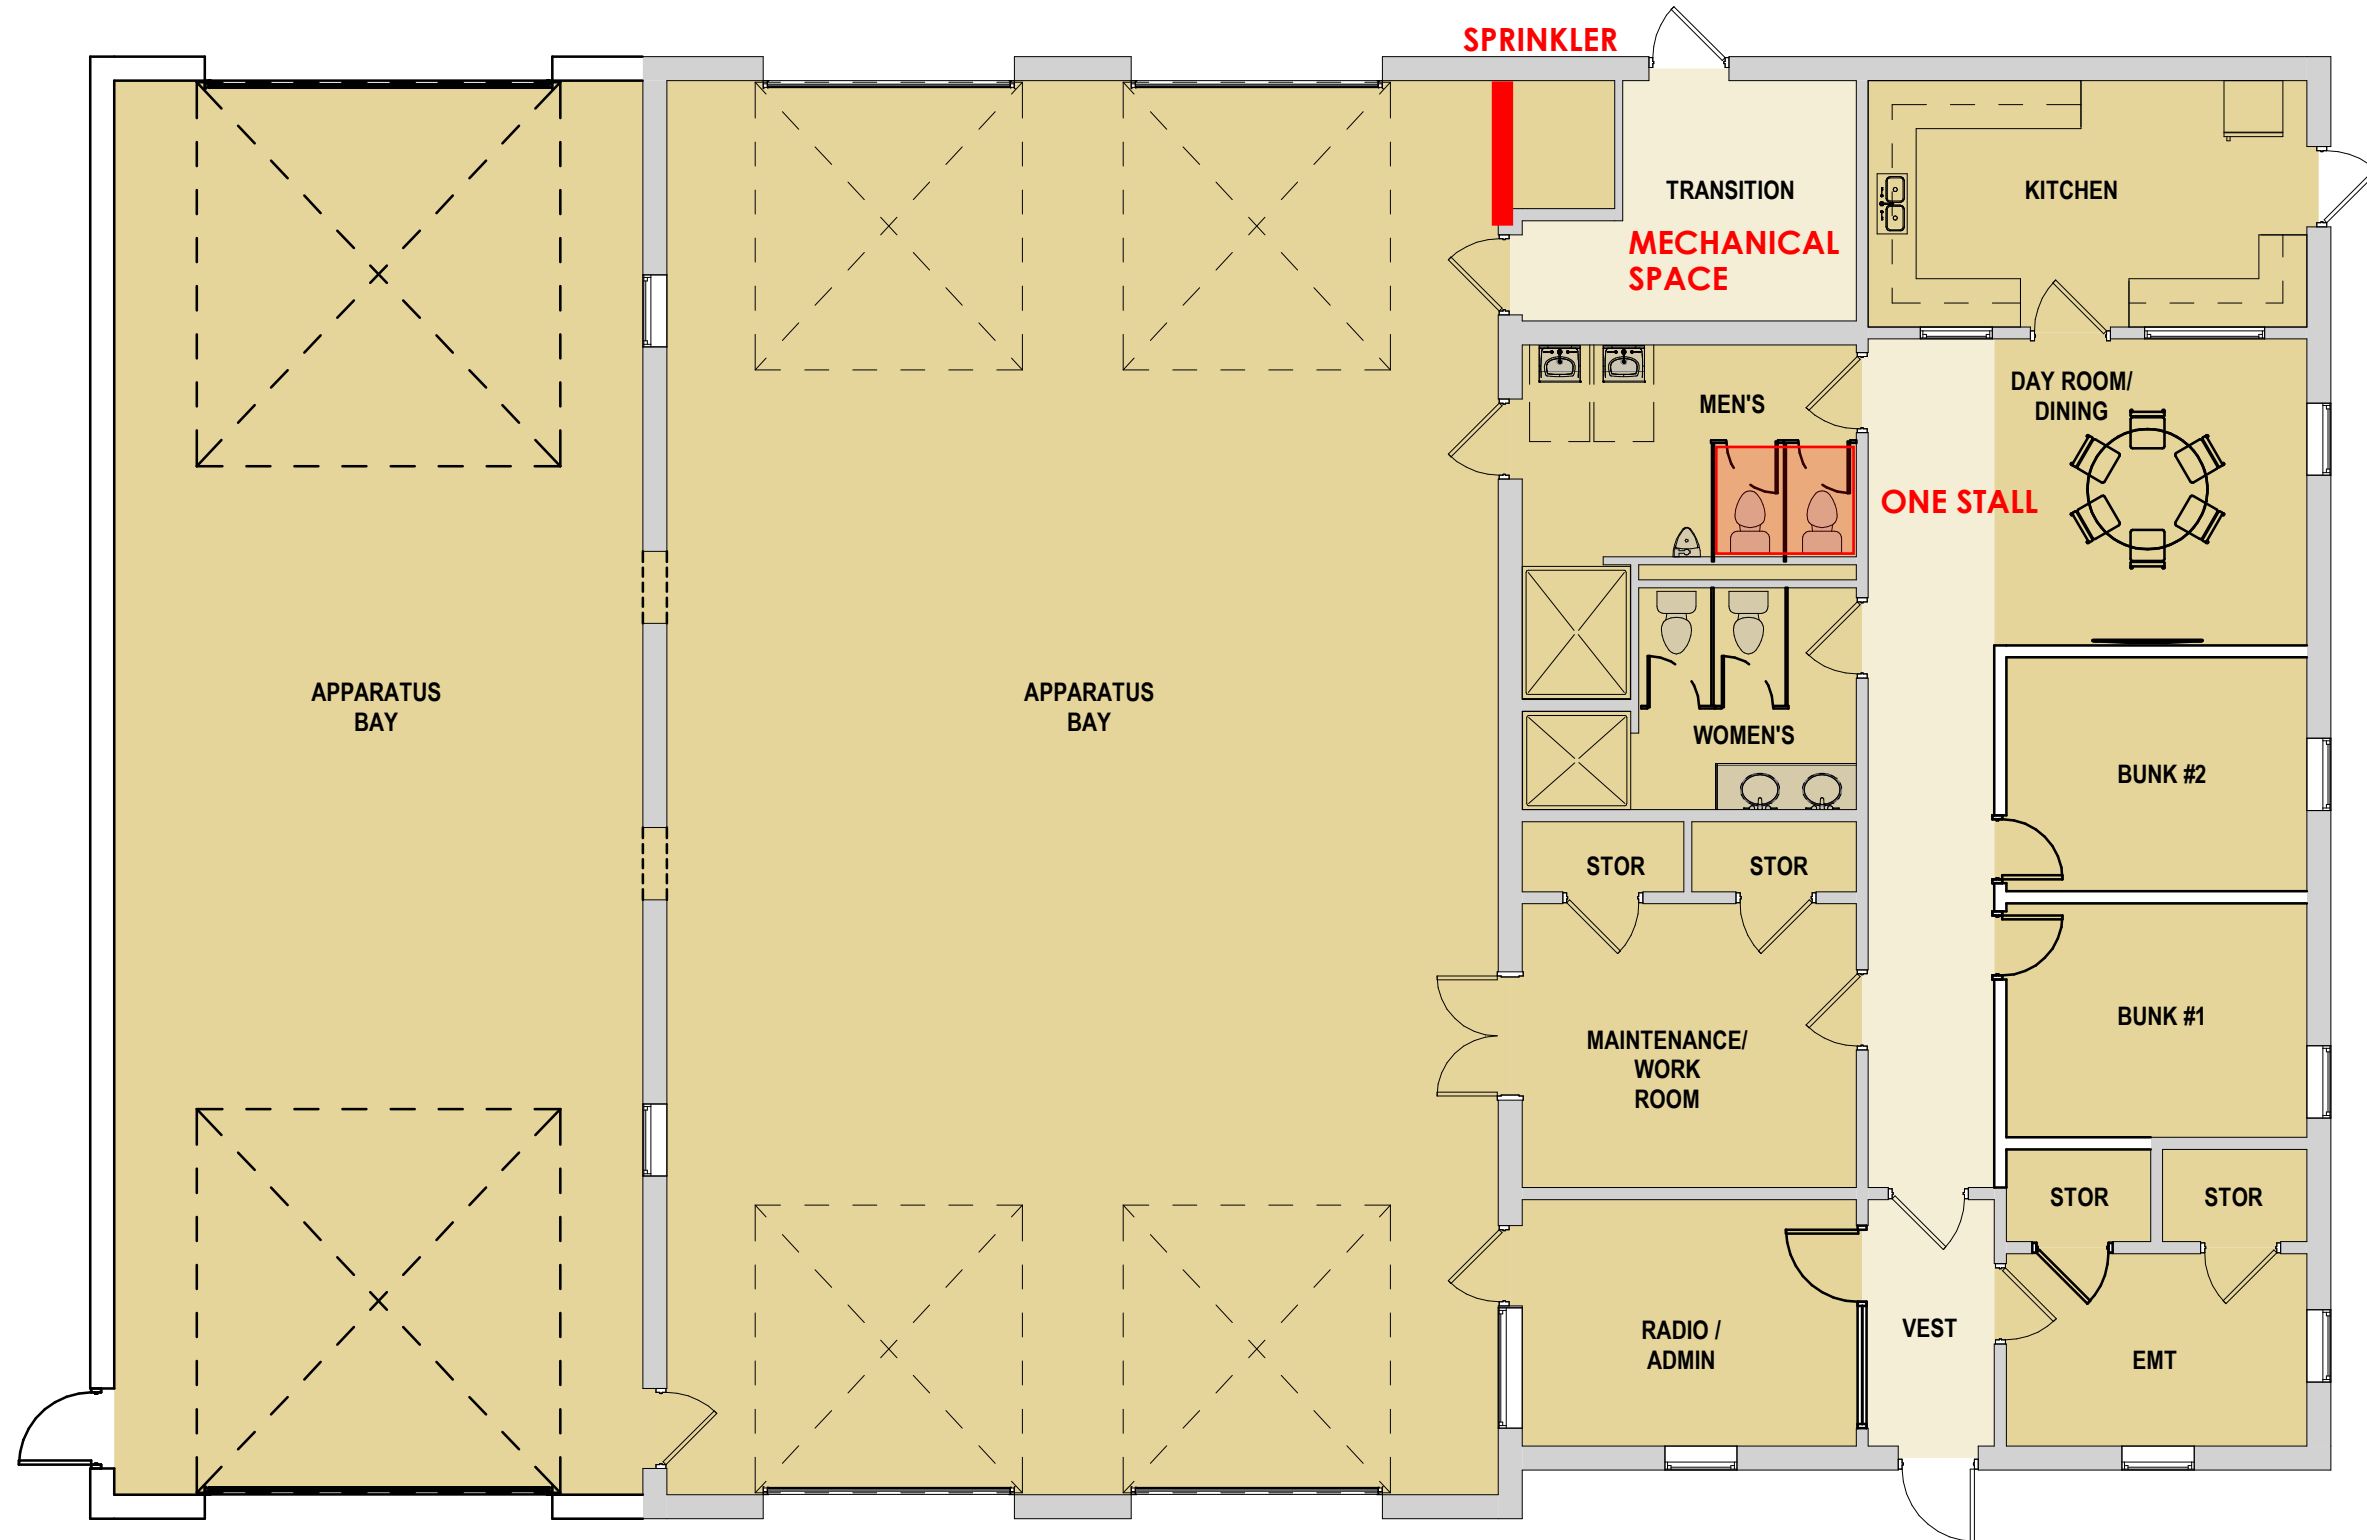

PEPPERELL, MA

CONCEPTUAL DESIGN  
JANUARY 18, 2022

PROPOSED FIRE SUBSTATION RENOVATION

FLOOR PLAN  
SCALE: 1/8" = 1' - 0"

**Tecton**  
ARCHITECTS